

BURGESS & NIPLE
 6085 REED ROAD
 COLUMBUS, OHIO 43229

ENGINEERING
 Ohio Department of Natural Resources

OHIO DEPARTMENT OF NATURAL RESOURCES
 FERNWOOD STATE FOREST
 SHOOTING RANGE IMPROVEMENTS
 JEFFERSON COUNTY, OHIO


DESIGNED BY: S. YATES
 DRAWN BY: S. DISARNO
 CHECKED BY: S. TORRES
 APPROVED BY: S. TORRES

JOB NUMBER: DNR-189017
 SCALE: NOTED
 DATE: OCTOBER 30, 2016
 REVISION:


STORMWATER POLLUTION PREVENTION PLAN (SWP3) PLAN

C-901

(SWP3) PLAN - TRAP RANGE
 SCALE 1" = 50'

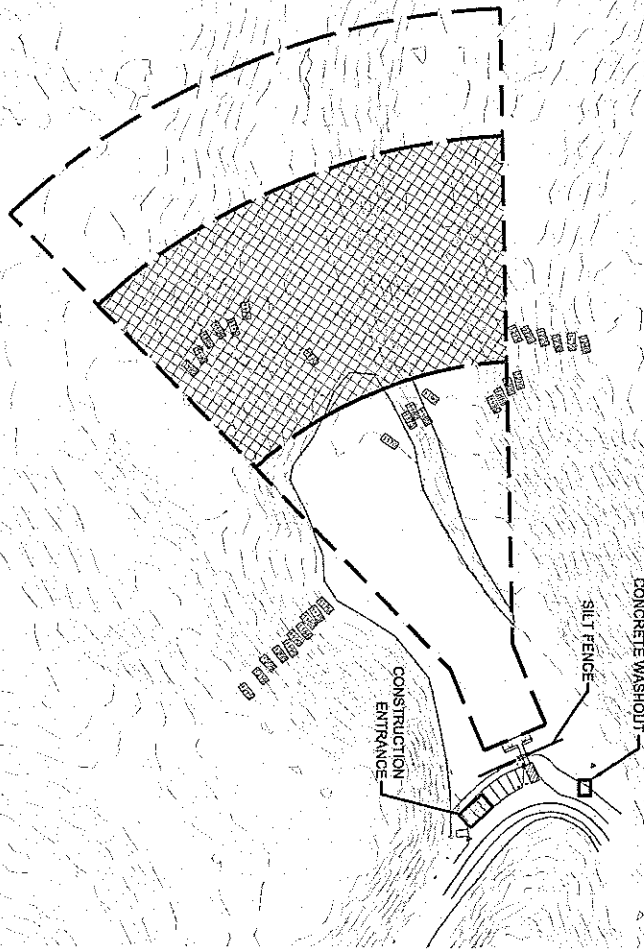

(SWP3) PLAN - RIFLE AND PISTOL RANGES
 SCALE 1" = 50'

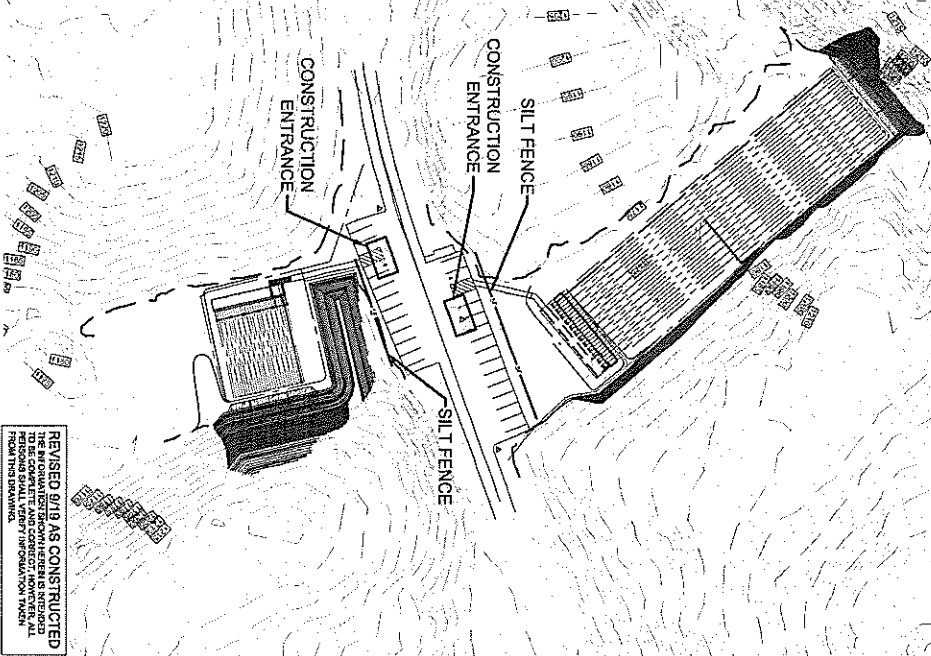

REVISED GRID AS CONSTRUCTED
 TO BE COMPLETE AND CORRECT, HOWEVER, ALL
 INFORMATION TAKEN FROM THIS DRAWING.



**25 YD. PISTOL RANGE
 LOCATION SITE PLAN**



NOTE
 1. SEE R-020 FOR DEMONSTRATION IN THIS AREA

REVISED 9/19 AS CONSTRUCTED
 THE APPROVEMENTS SHOWN HEREIN IS ENTERED
 INTO THE PUBLIC RECORDS OF THE COUNTY OF
 JEFFERSON, OHIO. ANY CHANGES TO THIS
 PLAN SHALL BE MADE BY A REGISTERED
 PROFESSIONAL ENGINEER.

